


REVISIONS	BY
1	3-31-02

Lattanzio & Associates
 Architecture • Planning
 (831) 662-3515
 19 Seascape Village • Aptos, CA 95003

JOB COPY
 APPROVED BY THE COUNTY OF SANTA CRUZ
 "INSPECTION SERVICES"
 DATE: _____ PERMIT NO: _____
 DRAWING OFFICER: _____
 NOTICE: THESE PLANS AND SPECIFICATIONS
 MUST REMAIN ON THE JOB SITE AT ALL TIMES.
 THEY SHALL NOT BE ALTERED WITHOUT THE
 WRITTEN PERMISSION OF THE BUILDING
 INSPECTION DEPARTMENT.

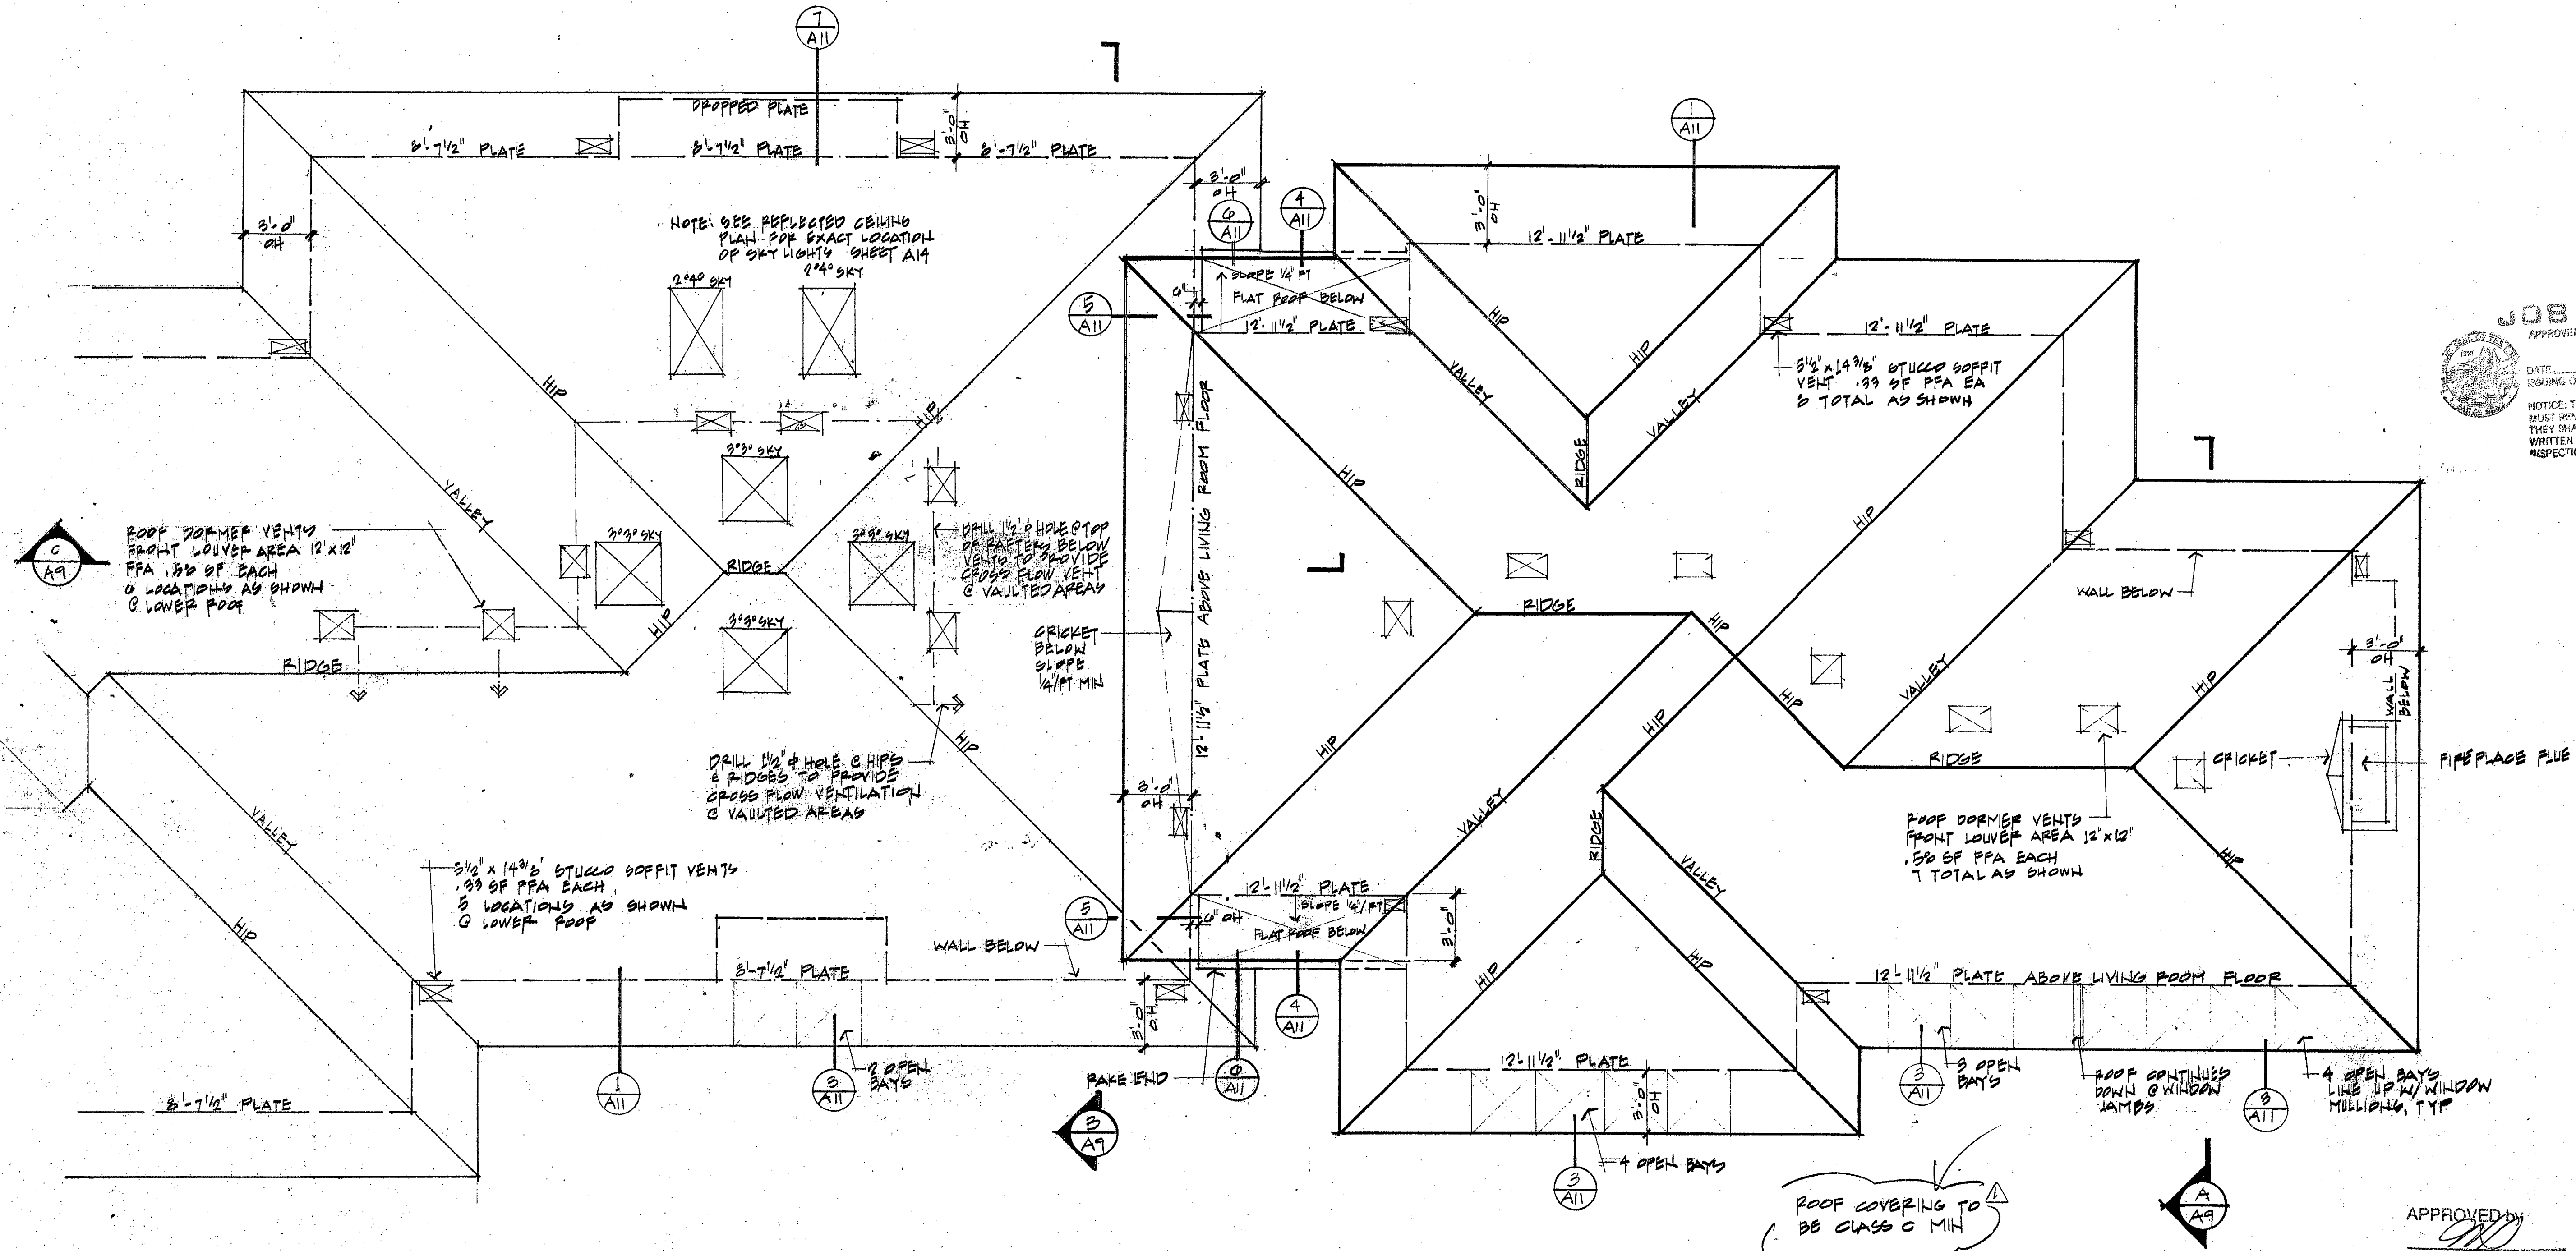

ROOF PLAN @ MAIN WING
 1/4" = 1'-0"

APPROVED BY
[Signature]
 Building Plan Check
 on 5/1/02

ROOF PLAN - MAIN WING

BOUSMAHA RESIDENCE
 MOCKINGBIRD RIDGE ROAD
 APTOS, CA

DATE	1-22-02
SCALE	
DRAWN	
JOB	
SHEET	A5
OR SHEETS	